



APPLICATION SUPPLEMENTAL FORM

Onsite Wastewater System

File Nbr: **2021110048**
County: York

Name: ALTERNATIVE SEPTIC SERVICES

Address:

168 HWY 274 155
LAKE WYLIE, SC 29710

Program Code: 360

Type Facility: HOUSE

System Code:

Subdivision

Site: RIPPLEROCK RD

TM No.: 737-00-00-023


Block: RIPPLEROCK RD Lot: 2-A

FORT MILL, SC 29715

Water Supply: PRIVATE

ACTUAL INSTALLATION

(NTS)

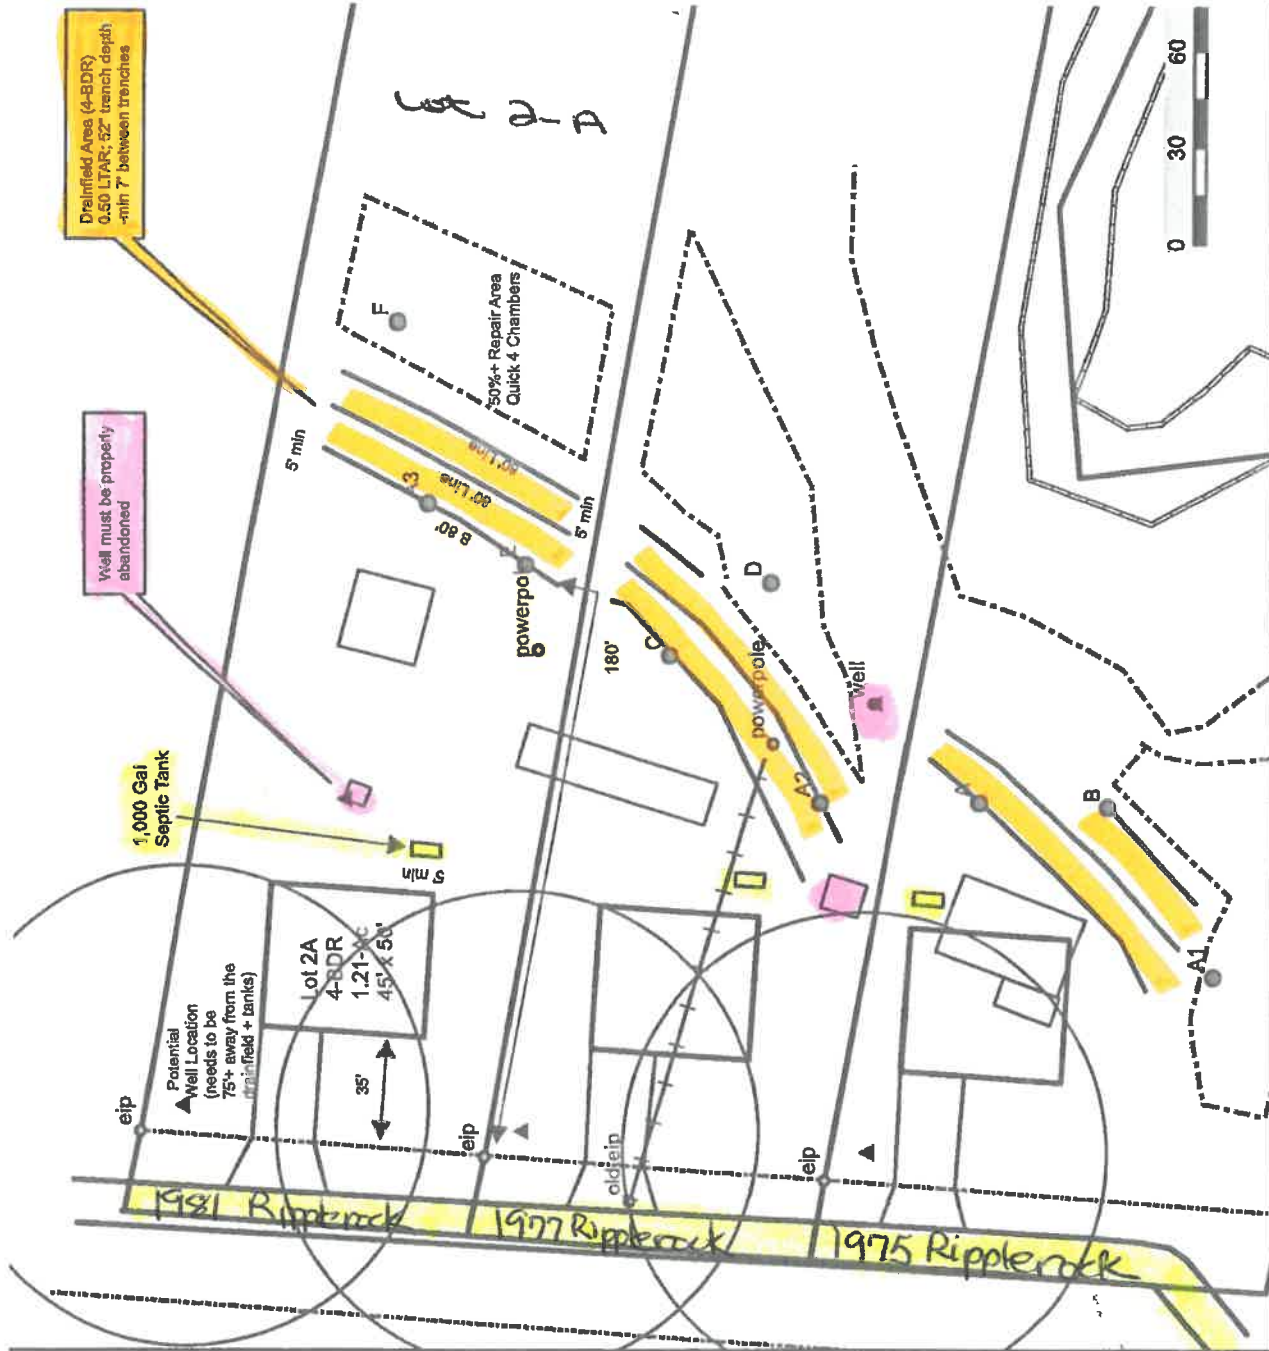



PERMIT TO CONSTRUCT
Onsite Wastewater System

File Nbr: 2021110048
County: York

Name: ALTERNATIVE SEPTIC SERVICES

Program Code: 360

Type Facility: HOUSE

Address: 168 HWY 274 155
LAKE WYLIE, SC 29710

System Code: 814

Subdivision:

Site: RIPPLEROCK RD
FORT MILL, SC 29715

TM No.: 737-00-00-023

Block: RIPPLEROCK RD Lot: 2-A

Water Supply: PRIVATE

PERMIT TO CONSTRUCT SYSTEM SPECIFICATIONS

Daily Flow (gpd): 480

Tank Sizes (gal): Septic Tank: 1000

Pump Chamber:

Grease Trap:

LTAR: .50

Trenches: Length (ft): 240 Width (in): 36 Max. Depth (in): 52 Agg. Depth (in): 12"

Min Pump Capacity:

gpm at ft. of head Alternative Product: INFILTRATOR QUICK4 CHAMBER

SPECIAL INSTRUCTIONS/CONDITIONS

THIS PERMIT IS SITE SPECIFIC. ANY CHANGES TO THE SYSTEM MUST BE APPROVED BY DHEC. ALTERNATIVE TRENCH PRODUCTS APPROVED UNDER STATE RULES AND REGULATIONS MAY BE SUBSTITUTED. ANY UNAPPROVED CHANGES WILL VOID THIS PERMIT.

Installers must contact the local Environmental Affairs office by 10:00 AM on the day prior to installation in order to schedule a time for the final inspection.

If a Department representative does not arrive within 30 minutes of the scheduled time, the installer may conduct the final inspection.

When a contractor self-inspection occurs, the installer must complete the DHEC form 3978, Approval to Operate Contractor Self-Inspection.

The installer must submit DHEC form 3978 within 2 business days of the completion of the installation.

System designed for a (4) bedroom residence.

System design and soil work provided by Steven Melin, Soil Classifier, SC#82.

Keep system 75 feet from all new or existing wells.

Do not park, build or drive drainfield location.

Do not install utilities or sprinkler systems in drainfield location.

Contact Cathy Phillips at 803-909-7377 if questions regarding the permit.

PERMIT TO CONSTRUCT SYSTEM DIAGRAM

(NTS)

Seller Signature Ronil Chudgar

Buyer Signature

Listing Agent Buyer Agent Cherie Burris

See Supplemental Form

Issued/Revised By: Cathy Phillips

Date: 11-29-2021

This Permit is Appealable Under the Administrative Procedures Act.

This permit will expire and become null and void five (5) years from the issuance date.

There may be an Additional Fee for Changes in this Permit that Require a Site Reevaluation.



APPROVAL TO OPERATE

Department Staff Inspection - Onsite Wastewater System

File Nbr: **2021110048**

County: York

Name: ALTERNATIVE SEPTIC SERVICES
Type Facility: HOUSE
Subdivision
Block: RIPPLEROCK RD Lot: 2-A

Address:
168 HWY 274 155
LAKE WYLIE, SC 29710
Site: RIPPLEROCK RD
FORT MILL, SC 29715

Program Code: 360
System Code:
TM No.: 737-00-00-023
Water Supply: PRIVATE

ACTUAL INSTALLATION

(NTS)

FINAL APPROVAL

Installer:
Septic Tank Mfg:
Pump Chbr Mfg:
Pump Mfg:
Pump Model:
Grease Trap Mfg:
Alternative Product:
Aggregate Type:
Aggregate Depth (in):
Trench Width (in):
Trench Depth (in):
Fill Cap:
Fill Cap Depth (in):
Well Installed:
Well Dist (ft):
Building Dist (ft):
Property Dist (ft):
Water Dist (ft):

Tank Size (gal):
Pump Chamber Size (gal):
Elevation Readings:
Plumbing Stubout:
Septic Tank Inlet:
Septic Tank Outlet:
Pump Chamber Inlet:
Line No.

_____	_____
_____	_____
Comments: _____

Licensed Installer
Printed Name _____ License No. _____

I hereby certify the system was installed in accordance with the referenced permit and R.61-56 and is in an exposed condition ready for inspection.

Licensed Installer Signature _____ Date _____

Office Use Only

APPROVAL BY DHEC TO OPERATE

THIS CERTIFICATE OF FINAL APPROVAL IN NO WAY GUARANTEES THE LIFE OF THE SYSTEM OR THAT IT WILL FUNCTION PROPERLY UNDER ANY OR ALL CONDITIONS

Approved By: _____ Date: _____